User:

Wednesday, 12/13/2006 2:48:19 PM

Kim Johnston

## **Process Sheet**

Customer

: CU-DAR001 Dart Helicopters Services

Job Number

: 29942

**Estimate Number** 

: 11,190

P.O. Number This Issue

Prsht Rev.

: HIM

: 12/13/2006

: NC

: WIA

1

S.O. No. : N/A

: SMALL /MED FAB Type

First Issue : 28229 **Previous Run** 

Written By

Checked & Approved By Comment

New issue KJ/JLM A04.09.02

**Drawing Name** 

: TUBE ASSEMBLY 25"

**Part Number** 

: D3298001 : D3298 REV A2

**Drawing Number** Project Number

: N/A

**Drawing Revision** Material

: A2 : NIA

**Due Date** 

: 1/5/2007

Qty:

5 Um:

Each

rece.

鳌 **Additional Product** 

Job Number:



Seq. #:

Machine Or Operation:

Description:

1.0

M6061T6T0375W035

6061-T6 Tube .375 x.035W



Comment: Qty.

2.1875 f(s)/Unit Total: 10.9373 f(s)

Cut tube to length as per Dwg D3298

Material: 6061-T6 (WW-T-700/6) tubing Ø0.375" x 0.035" wall (M6061T6T0.375W.035)

Identify as D3298-001

2.0

Comment: Qty.:

Total: 2.0000 Each(s)/Unit

10.0000 Each(s)

Sleeve Pick:

Part Number Description

MS20819-6D Sleeve

M103044

07-01-18

3.0

AN8186D

Nut

Comment: Qty.:

2.0000 Each(s)/Unit Total: 10.0000 Each(s)

Coupling Nut

Pick:

Part Number Description

Batch

AN818-6D

103154

# **Dart Aerospace Ltd**

W/O:		WORK ORDER CHANGE	S				
DATE	STEP	PROCEDURE CHANGE	Ву	Date	Qty	Approval Chief Eng / Prod Mgr	Approval QC Inspector
		·		·			
Part No	•	PAR #: Fault Category:	NCR: Yes	No DQA	:: <del> </del>	∑ Date: <u></u>	17/01/19
			QA:	N/C Closed	l:	_ Date: _	

NCR:		W	WORK ORDER NON-CONFORMANCE (NCR)									
		Description of NC		Corrective Action Section B	<del></del>	V :5 4:		Approval QC inspector				
DATE	STEP	Description of NC Section A	Initial Chief Eng	Action Description Chief Eng	Sign & Date	Verification Section C	Approval Chief Eng					
* .		÷										
			·									
			·									
		·										

NOTE: Date & initial all entries

Date: Wednesday, 12/13/2006 2:48:19 PM User: Kim Johnston **Process Sheet** Drawing Name: TUBE ASSEMBLY 25" Customer: CU-DAR001 Dart Helicopters Services Job Number: 29942 Part Number: D3298001 Job Number: Description: Seq. #: **Machine Or Operation:** SMALL & MEDIUM FAB RESOURCE 1 SMALL FAB 1 4.0 Comment: SMALL & MEDIUM FAB RESOURCE 1 Bend tube as per template D3298-001T1 & Dwg D3298 Flare end as per Dwg D3298. Ensure that sleeves and coupling are installed first QC5 INSPECT WORK TO CURRENT STEP 5.0 Comment: INSPECT WORK TO CURRENT STEP PACKAGING RESOURCE #1 6.0 Comment: PACKAGING RESOURCE #1 Identify with P/N and B/N using permanent fine point marker, then Stock Location: <u>5</u>+3 +8 QC21 7.0 Comment: FINAL IN SPECTION/W/O RELEASE CZ07/01/19 Job Completion

# **Dart Aerospace Ltd**

W/O:		WORK ORDER					
DATE	STEP	PROCEDURE CHANGE	Ву	By Date		Approval Chief Eng / Prod Mgr	Approval QC inspector
					i de la companya de l		
		·					
Part No	:	PAR #: Fault Category:	NCR: Yes	No DQ	A:	Date: _	
			QΔ·	N/C Close	٠d٠	Date:	


		WORK ORDER NON-CONFORMANCE (NCR)										
	Description of NC		Corrective Action Section B	· · · · · · ·	Varification	Approval	Annroyal					
STEP	Section A	Initial Chief Eng	Action Description Chief Eng	Sign & Date	Section C	Chief Eng	Approval QC Inspector					
	•											
						}						
							·					
	STEP	STED Description of NC	STEP Description of NC Section A Initial	STEP Description of NC Section A Initial Action Description	STEP Description of NC Section A Initial Action Description Sign &	STEP Section A Initial Action Description Sign & Verification Section C	STEP Description of NC Section A Proval Initial Action Description Sign & Section C Chief Eng					

NOTE: Date & initial all entries





DESIG	**	DRAWN BY	DART AEROSPACE LTD HAWKESBURY, ONTARIO, CANADA				
CHECK	ED ,	APPROVED	DRAWING NO.	REV. A			
	df	#	D3298 SHEET 1	OF 7			
DATE		L	TITLE	SCALE			
04.0	7.06		TUBE ASSEMBLIES	NTS			
Α		04.07.06	NEW ISSUE				
Αï	A B	04,11.30	CORRECT VIEW D3298-003; 16.50 WAS	15.75			
A2	dif	20.20.50	FOR D3298-001/-003 16.00 WAS 16.50	) 			

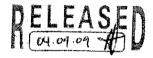

	P/N	TEMPLATE	CUT LENGTH OF TUBE	MS20819-6D SLEEVE	AN818-6D NUT	LL DESC.	MATERIAL		0 4	ostV.
۷I	D3298-001	D3298-001T1	25.00	/2	2	TUBE ASS'Y	6061-T6 0.375 OD x 0.035 W	(WW-T-700/6)	Removed	A MANUAL
			000194			TUDE 400%	6061-T6 0.375 OD x 0.035 W	(WW-T-700/6)		
	D3298-003	D3298-003T1	27.00	2	2	TUBE ASS'Y	6061-16 0.373 OD X 0.033 W	(4444-1-100/0)		
	D3298-005	D3298-005T1	23.00	2	2	TUBE ASS'Y	6061-T6 0.375 OD x 0.035 W	(WW-T-700/6)		
	D3298-007	D3298-007T1	8.00	2	2	TUBE ASS'Y	6061-T6 0.375 OD x 0.035 W	(WW-T-700/6)		
	D3298-009	D3298-009T1	6.00	1	1	TUBE ASS'Y	6061-T6 0.375 OD x 0.035 W	(WW-T-700/6)	4	
	D3298-011	D3298-011T1	8.00	2	2	TUBE ASS'Y	6061-T6 0.375 OD x 0.035 W	(WW-T-700/6)		:
	D3298-013	D3298-013T1	10.00	2	2	TUBE ASS'Y	6061-T6 0.375 OD x 0.035 W	(WW-T-700/6)		
	D3298-015	D3298-015T1	14.00	1.	1	TUBE ASS'Y	6061-T6 0.375 OD x 0.035 W	(WW-T-700/6)		
							<u> </u>	·····		

### Notes:

- (1) TUBING ASSEMBLIES TO BE CUT AND BENT IN ACCORDANCE WITH TEMPLATES.
- (2) TUBES TO BE FLARED 37° TO MATE WITH FITTINGS MADE TO MS33514.
- (3) ENSURE SEAMLESS TUBING IS USED.
  - (4) 5052 (WW-T-700/4) TUBING MAY BE SUBSTITUTED WHEN 6061 TUBING IS NOT AVAILABLE.
  - (5) TOLERANCES ARE PER DART QSI 018 UNLESS OTHERWISE NOTED.

(6) ALL DIMENSIONS ARE IN INCHES


(7) IDENTIFY WITH DART P/N & B/N USING FINE POINT PERMANENT MARKER

SHOP COPY RETURN TO ENGINEERING UNCONTROLLED COPY SUBJECT TO AMENDMENT






DESIGN	DRAWN BY	DART AEROSI HAWKESBURY, ONTA	· · · · ·
CHECKED	APPROVED.	DRAWING NO.	REV. A SHEET 2 OF 7
DATE		TITLE	SCALE
04.07.06		TUBE ASSEMBLIES	NTS

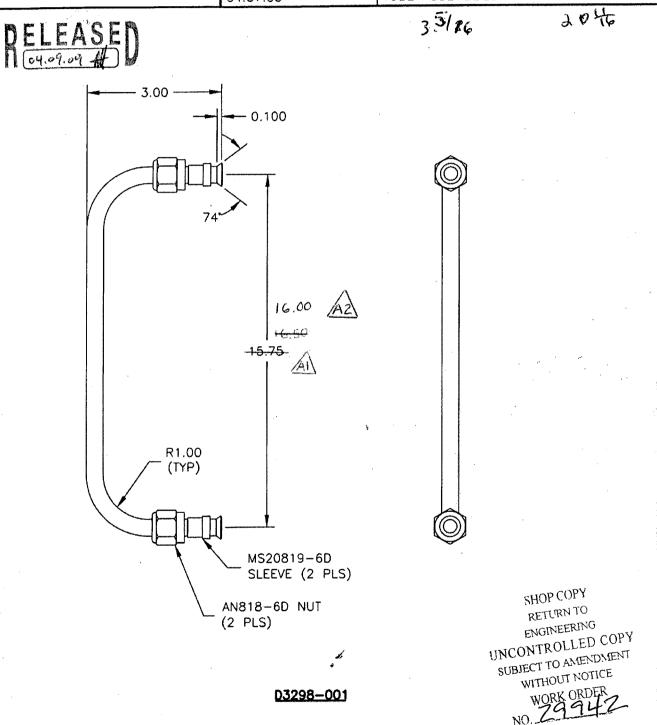




DESIGN -	DRAWN BY	DART AEROSI HAWKESBURY, ONTA	
CHECKED	APPROVED	DRAWING NO.	REV. A SHEET 3 OF 7
DATE	1 1	TITLE	SCALE
04.07.06		TUBE ASSEMBLIES	NTS

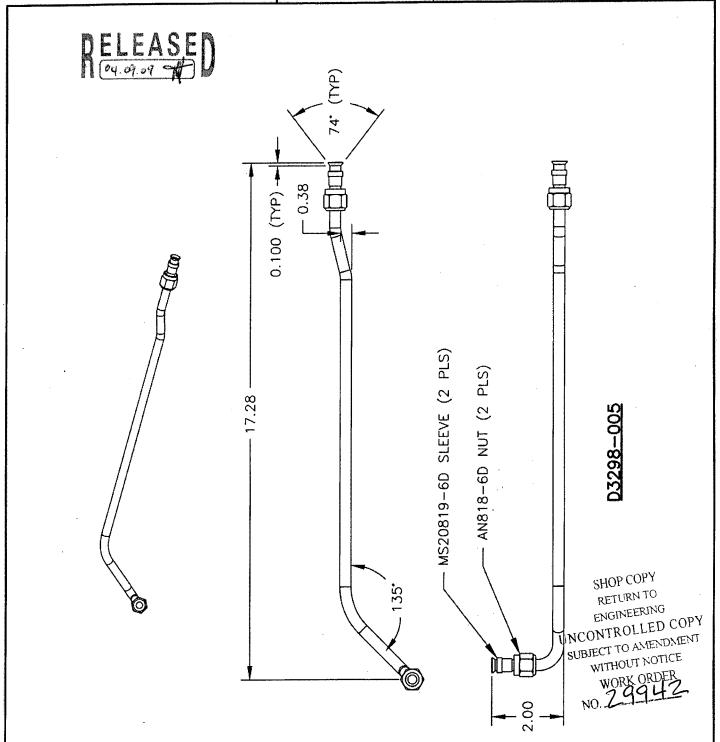






DESIGN	DRAWN BY	DART AEROSF HAWKESBURY, ONTAF	
CHECKED	APPROVED	DRAWING NO.	REV. A SHEET 4 OF 7
DATE		TITLE	SCALE
04.07.06		TUBE ASSEMBLIES	NTS

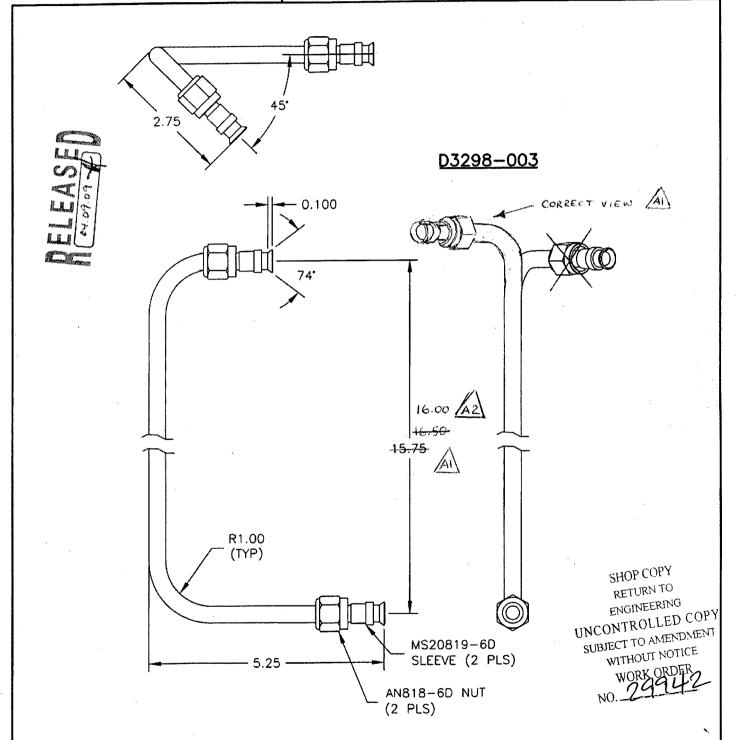







DESIGN	DRAWN BY	DART AEROSF HAWKESBURY, ONTAR	
CHECKED	APPROVED	DRAWING NO. D3298	REV. A SHEET 5 OF 7
DATE		TITLE	SCALE
04,07.06		TUBE ASSEMBLIES	NTS

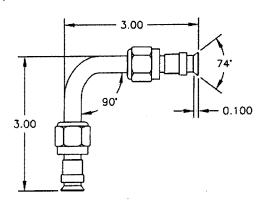


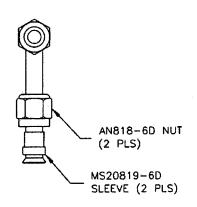

### D3298-007

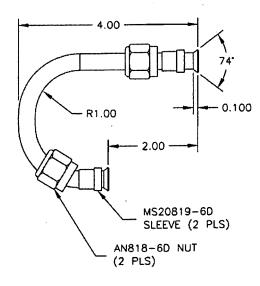

D3298-013

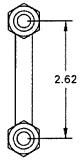



SHOP COPY RETURN TO ENGINEERING UNCONTROLLED COPY SUBJECT TO AMENDMENT WITHOUT NOTICE







DESIGN	DRAWN BY	DART AEROSF HAWKESBURY, ONTAR	
CHECKED	APPROVED	DRAWING NO.	REV. A SHEET 6 OF 7
DATE		TITLE	SCALE
04.07.06		TUBE ASSEMBLIES	NTS

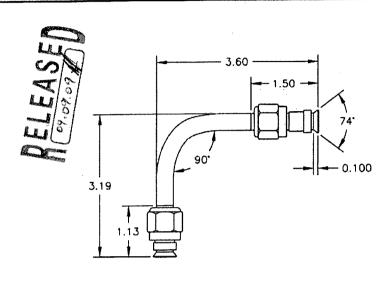


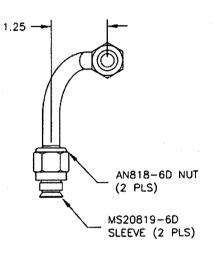

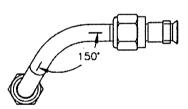

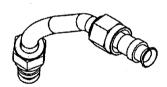

D3298-011

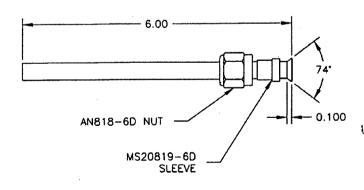


SHOP COPY RETURN TO ENGINEERING UNCONTROLLED COPY SUBJECT TO AMENDMENT


D3298-009





DESIGN	DRAWN BY	DART AEROS HAWKESBURY, ONT.	
CHECKED	APPROVED	DRAWING NO.	REV. A
#	91	D3298	SHEET 7 OF 7
DATE		TITLE	SCALE
04.07.06		TUBE ASSEMBLIES	NTS

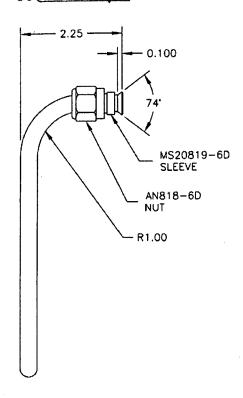

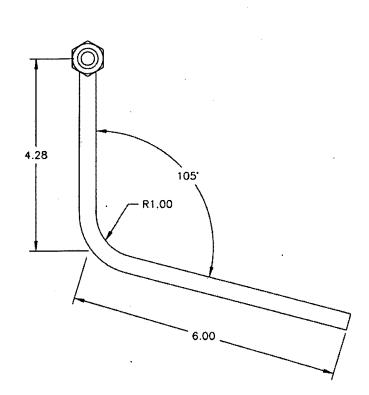

D3298-015

SHOP COPY RETURN TO ENGINEERING UNCONTROLLED COPY SUBJECT TO AMENDMENT WITHOUT NOTICE

